

HISTORY RECORDS:	
Date	Description
07/18/18	PLANNING SUBMITTAL

PLANS PREPARED BY:



CONTACT:
CECILE WILLAROSA
PHONE NO.: (714) 472,0519
crvdesignbuildservices@gmail.com
OWNER:
MR. AERON ZAMORA
1476 S. SAN ANTONIO AVE.
POMONA CA. 91766
PHONE NO.: (909)643,7025



SAN ANTONIO DEVELOPMENT
1476 S. SAN ANTONIO AVENUE
POMONA CA 91766
APN: 8327 001 004

DRAWING CONTENT:

**AS BUILT
SITE PLAN**

SHEET NO.

A0-1

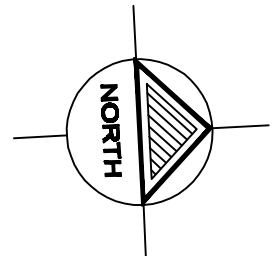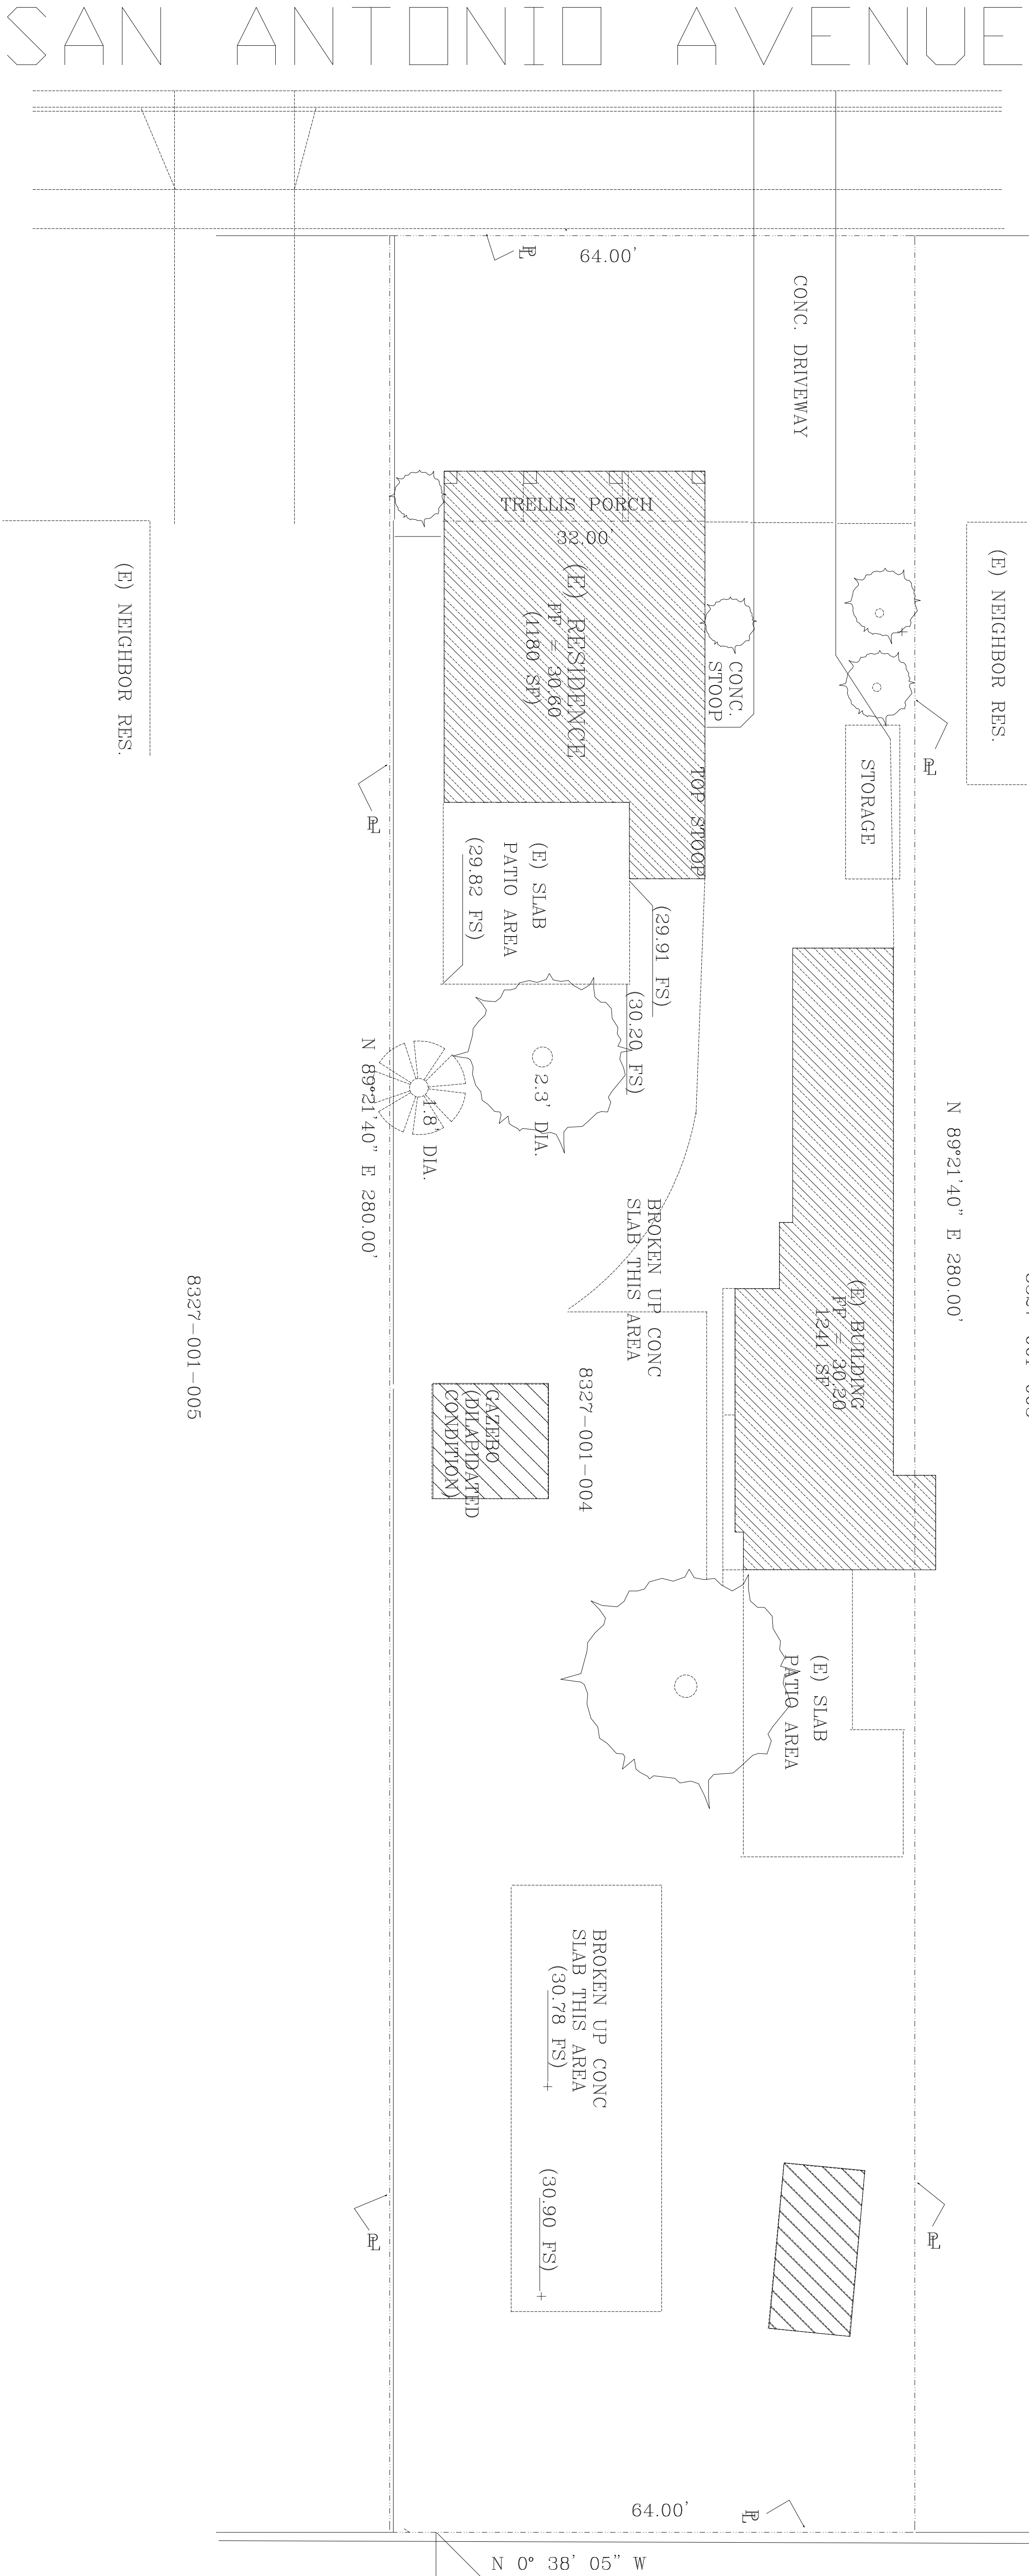

1

SITE PLAN

Scale: 1" = 10'

