


GENERAL NOTES:

- COORDINATE EXACT STRUCTURE COLUMN LOCATIONS WITH STRUCTURAL.
- PROVIDE PVC SCHED. 40 CONDUIT BELOW GRADE, RMC WHERE SUBJECT TO PHYSICAL DAMAGE AND UP TO A HEIGHT OF 8' ABOVE GRADE, EMT CONDUIT WITH RAINTIGHT COMPRESSION FITTINGS ELSEWHERE (U.O.N.).
- UNDERGROUND RACEWAYS SHALL BE INSTALLED A MINIMUM OF 36" BELOW GRADE TO TOP OF RACEWAY.
- CONTACT DIGALERT PRIOR TO PERFORMING ANY UNDERGROUND INSTALLATIONS.
- COORDINATE UNDERGROUND INSTALLATIONS WITH AS-BUILTS AND OTHER TRADES.
- MAINTAIN CODE REQUIRED CLEARANCES BETWEEN NEW UNDERGROUND RACEWAYS AND EXISTING UTILITIES AS REQUIRED. WHERE EXISTING UTILITIES ARE IN CONFLICT, A TRENCH DEEPER THAN 36" SHALL BE REQUIRED.
- ELECTRICAL EQUIPMENT SHALL BE MOUNTED IN ACCORDANCE WITH STRUCTURAL DRAWING PACKAGE REQUIREMENTS.
- THE FOLLOWING SYSTEMS ARE PART OF A DEFERRED SUBMITTAL BY OTHERS. ONLY THE UNDERGROUND RACEWAYS FOR THESE SYSTEMS ARE PART OF THIS PERMIT: BESS, EV, CCTV.

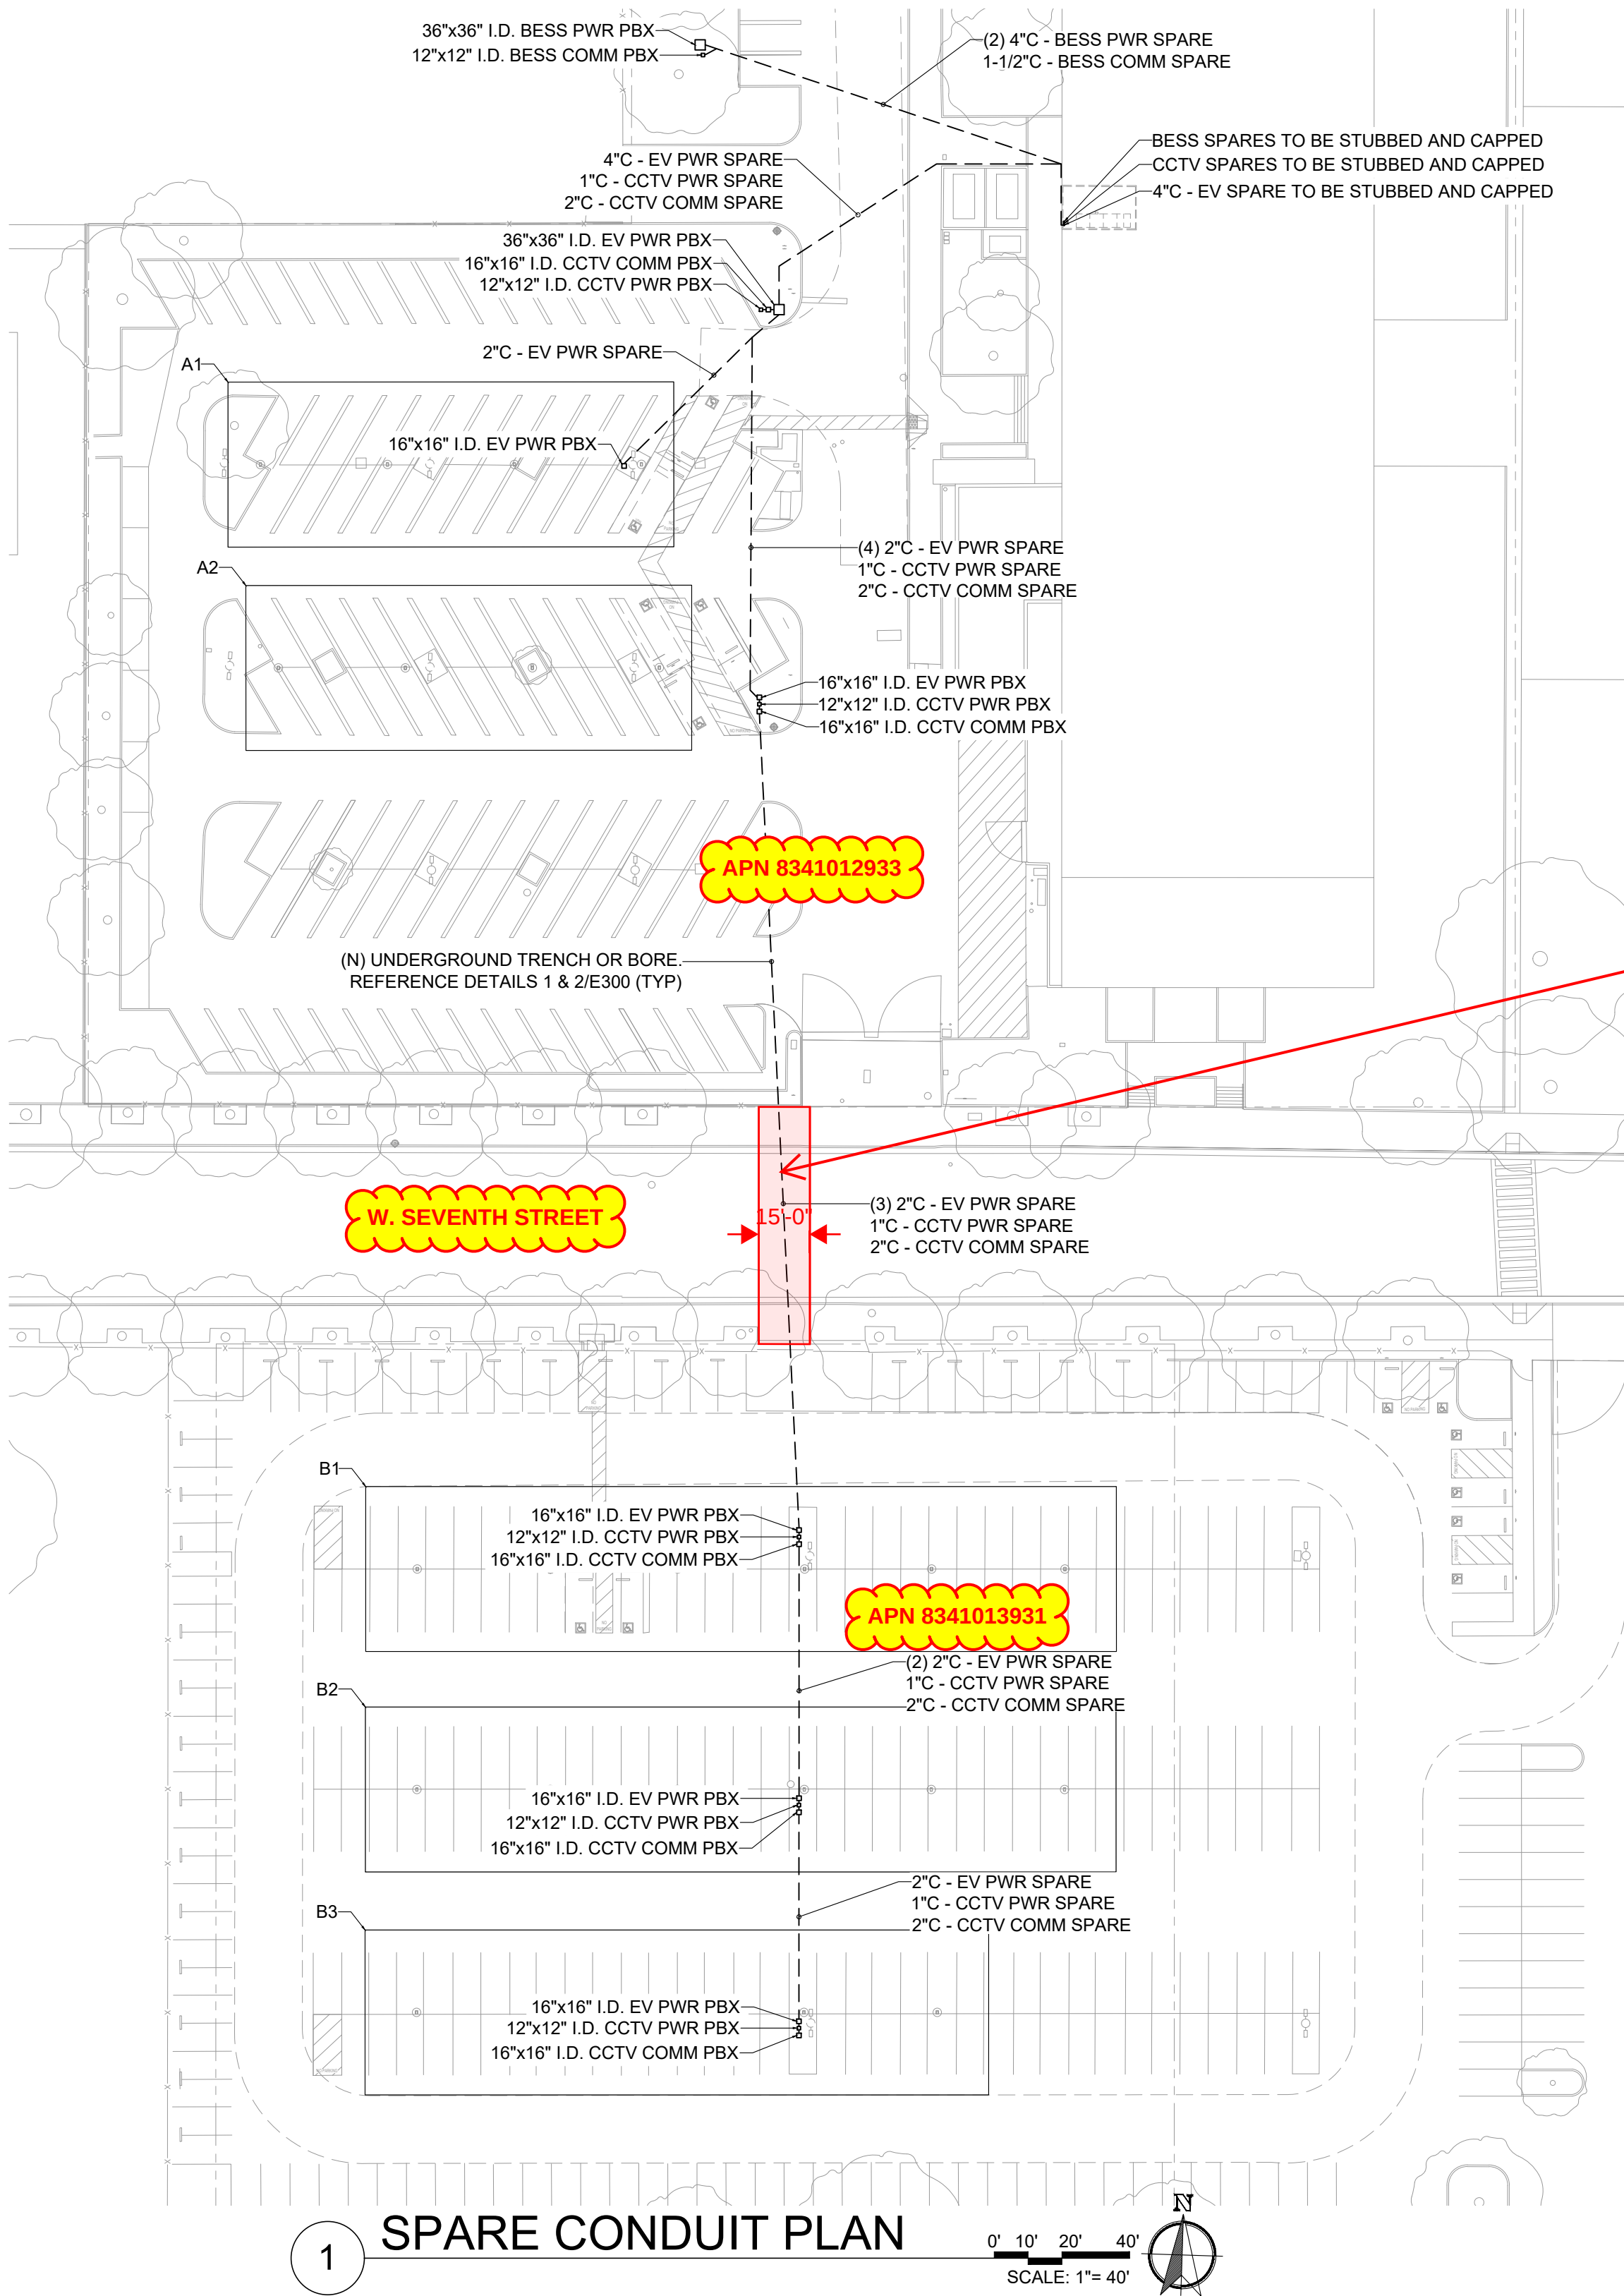

SYSTEM HOST

455 GOLDEN GATE AVE.
SAN FRANCISCO, CA 94102-3688
415.865.4200

SYSTEM DEVELOPER

siteologia

1651 RESPONSE RD, SUITE #300
SACRAMENTO, CA 95815
916-914-1929

ELECTRICAL ENGINEERING

nazarene engineering

2514 JAMACHA ROAD, #502-182
EI CAJON, CA 92019
619-333-0837

STRUCTURAL ENGINEERING

TEICHERT
SOLAR


10620 TREENA ST., STE. #140
SAN DIEGO, CA 92131
562-283-2970

ARCHITECT OF RECORD

M P V D E S I G N

2261 Market Street STE 5998
San Francisco, CA 94114
619.632.2883

ARCHITECT / ENGINEER OF RECORD

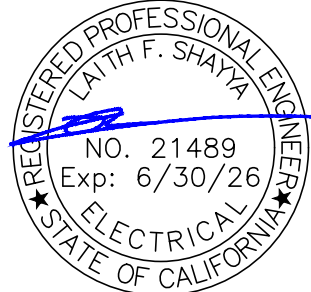

NO.	REVISION	DATE
	BACKCHECK 1	09.15.2025
DATE: 06.16.2025		
PROJECT		
JUDICIAL COUNCIL OF CALIFORNIA DISTRICT		
19-W1 POMONA		
COURTHOUSE SOUTH		
400 CIVIC CENTER PLAZA		
POMONA, CA 91766		

SHEET TITLE

SPARE
CONDUIT
PLAN

SHEET NO.:

E101